





BRIDE LAKE

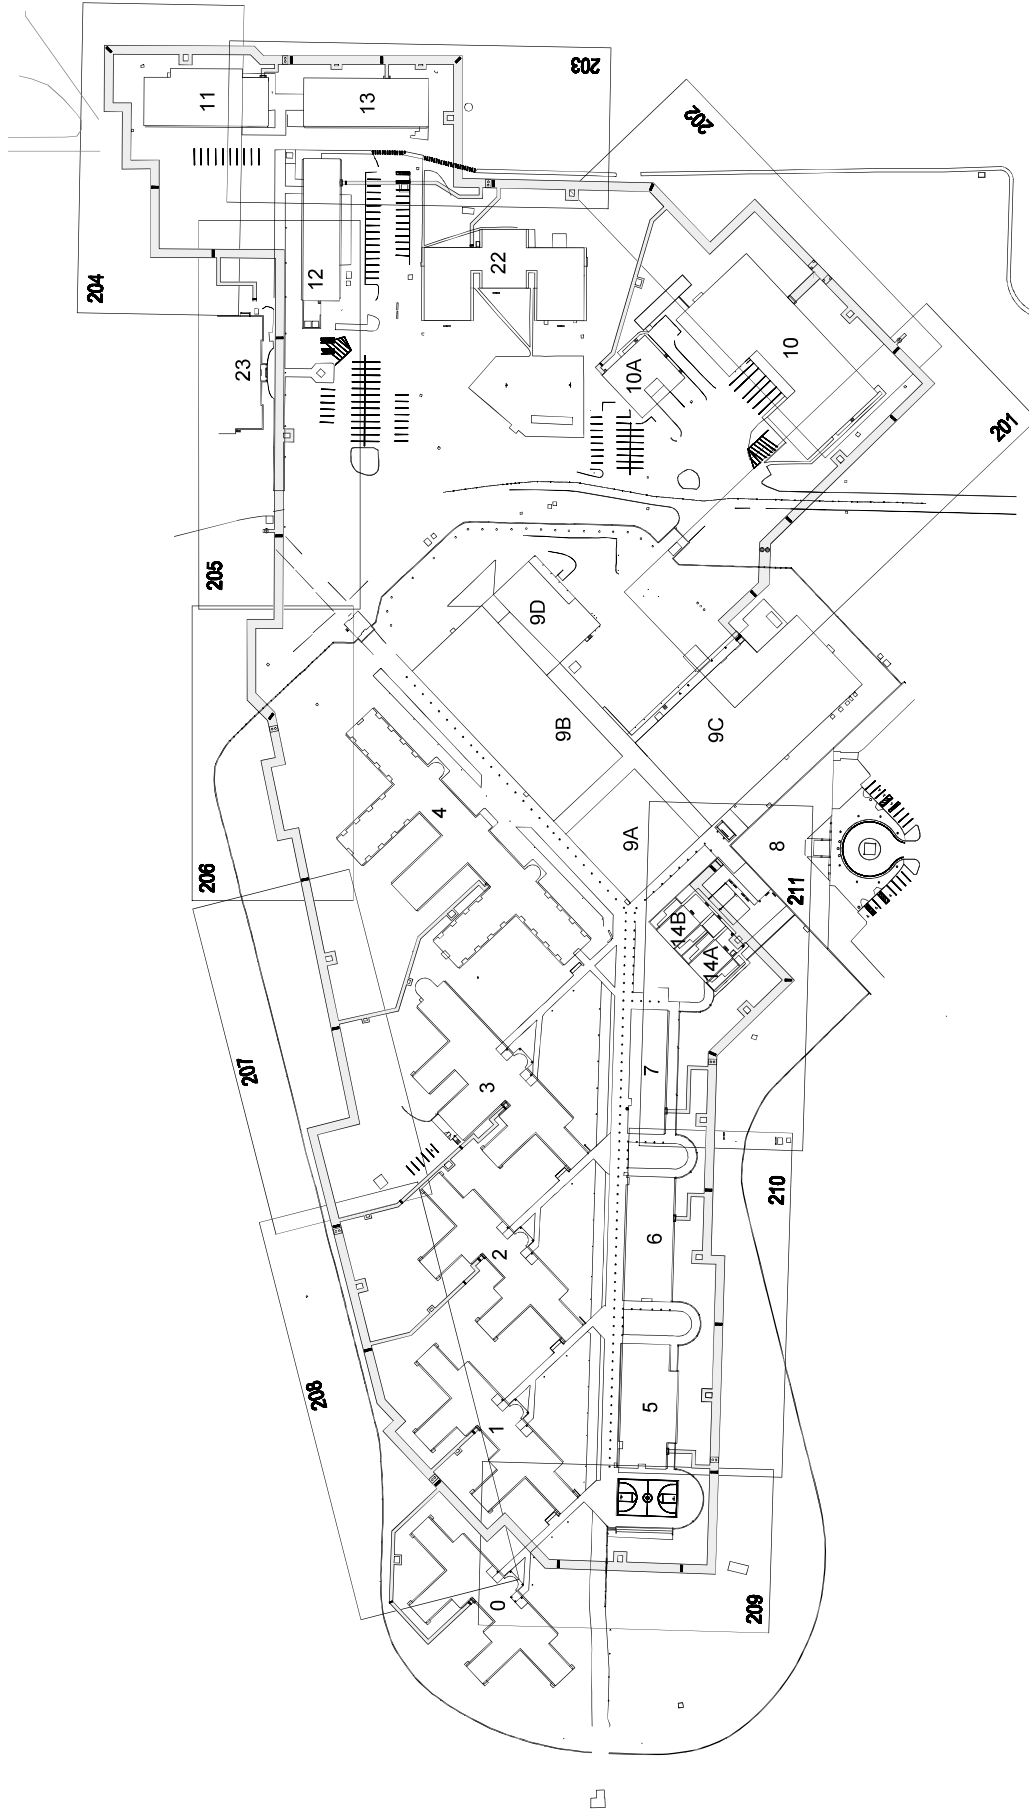

1 DISTRIBUTION PIPING SITE INDEX PLAN

SCALE: 1" = 80'

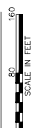

LEGEND:	
○ IRON PIN (FOUND)	■ SIGN
● REPAIR/DRILL HOLE (To Be Set)	■ POST
□ MONUMENT (FOUND)	○ GLY ANCHOR
○ MANHOLE	○ UTILITY POLE
○ DRAINAGE MANHOLE	○ WATER GATE
○ SANITARY MANHOLE	○ WATER METER
○ ELEC. MANHOLE	○ GAS VALVE
○ TELE. MANHOLE	○ GAS METER
○ "C" CATCH BASIN	○ TRANSFORMER
○ DECIDUOUS TREES	○ ELEC. METER
○ EVERGREEN TREES	○ MAIL BOX
○ SHRUB/BUSH	○ HAND HOLE
○ FLAG POLE	□ BUTTON BOX
○ A.C. UNIT	○ A.C. UNIT
○ TRAFFIC CONTROL BOX	○ TRAFFIC LIGHT POLE
---	BOUNDARY LINE
---	GUARD RAIL
---	UNDERGROUND (To Be Set)
---	U/G GAS LINE
---	U/G ELEC. LINE
---	WATER LINE
---	OVERHEAD UTILITIES
---	U/G TELE. LINE
---	CHAIN LINK FENCE
---	TREE LINE



**SURVEYING ASSOCIATES, LLC**  
201 CHRISTIAN LANE, BERLIN, CT 06037  
860-432-9328 860-437-4684 (FAX)

REVISIONS:

IMPROVEMENT LOCATION SURVEY  
RECORD DRAWING  
DISTRIBUTION PIPING  
SITE INDEX PLAN  
YORK CORRECTIONAL INSTITUTION  
CENTRAL PLANT & DISTRIBUTION  
NANTIC, CONNECTICUT

M&A PROJECT NO.: 1045488	DRAWN BY: GAO
SCALE: 1"=80'	CHECKED BY: GAO
DATE: 11/03/20	SHEET:
	AB200

2 DISTRIBUTION PIPING PROFILE

• HORZ SCALE: 1" = 20'  
VERT SCALE: 1" = 4'



●

IRON PIN (FOUND)

⬢

POST

⬢

MONUMENT (FOUND)

⬢

MANHOLE

⬢

DRAINAGE MANHOLE

⬢

SANITARY MANHOLE

⬢

ELEC. MANHOLE

⬢

TELE. MANHOLE

⬢

"C" CATCH BASIN

⬢

"C" CATCH BASIN

⬢

DECIDUOUS TREES

⬢

EVERGREEN TREES

⬢

SHRUB/BUSH

⬢

FLAG POLE

⬢

TRAFFIC CONTROL BOX

⬢

BOUNDARY LINE

⬢

GIARD RAIL

⬢

UNDERGROUND

⬢

U/G GAS LINE

⬢

U/G ELEC. LINE

⬢

WATER LINE

⬢

OVERHEAD UTILITIES

⬢

U/S TELE. LINE

⬢

CHAIN LINK FENCE

⬢

TREE LINE

⬢

IRON PIN (FOUND)

⬢

POST

⬢

MONUMENT (FOUND)

⬢

MANHOLE

⬢

DRAINAGE MANHOLE

⬢

SANITARY MANHOLE

⬢

ELEC. MANHOLE

⬢

TELE. MANHOLE

⬢

"C" CATCH BASIN

⬢

"C" CATCH BASIN

⬢

DECIDUOUS TREES

⬢

EVERGREEN TREES

⬢

SHRUB/BUSH

⬢

FLAG POLE

⬢

TRAFFIC CONTROL BOX

⬢

BOUNDARY LINE

⬢

GIARD RAIL

⬢

UNDERGROUND

⬢

U/G GAS LINE

⬢

U/G ELEC. LINE

⬢

WATER LINE

⬢

OVERHEAD UTILITIES

⬢

U/S TELE. LINE

⬢

CHAIN LINK FENCE

⬢

TREE LINE